


SAFE ROUTES PEEKSKILL

saferoutespeekskill@gmail.com www.saferoutespeekskill.com

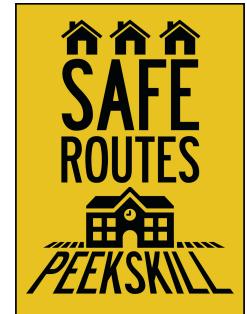

School Crosswalk Survey

Thank you for assisting the Safe Routes Peekskill in our School Crosswalk Survey. Safe Routes Peekskill is a coalition between the Peekskill PTO, Peekskill City School District, and Peekskill Walks. We appreciate your help in gathering this information. - *The Safe Routes Team*

Instructions

Please use the map labeled with your name contained in the Google Drive Folder that is shared with you. If you need any assistance with the Google Drive folder, or if you have questions, please contact Meghan [REDACTED] at [REDACTED]

- Please print your map out on regular letter paper, many maps are 2 to 4 pages. Or mark it digitally on your personalized file.
- Please bring/use 3 colors to mark up your maps. Suggested: Green, Blue and Red
- Use the Marking Legend to the right ->
- When complete, please photograph your map and email it to us, or if you marked it digitally, be sure it's saved in the Google Drive Folder and email us to know it's done. saferoutespeekskill@gmail.com

To Check:

- **Pedestrian Signs-** Is there a sign, note it's location, and if it has an arrow pointing to a crosswalk, or if it's further back and says "AHEAD" Here are possible sign types:



- **School Zone Signs-** Is there a sign, note it's location, if it has any hours listed, or a speed limit set. Please take a photo of the sign and label the spots on the map and the corresponding photo (use *SchoolName*Sign 1, *School Name*Sign 2, etc. Please email us the photo, or upload it to the Google Drive Folder.)




Safe Routes to School Peekskill

LEGEND:

- Existing pedestrian sign
- Existing "School Zone" sign (note hours)
- ▲ Existing "One-way School Days" sign (note hours)
- Existing crosswalk – OK condition
- Existing crosswalk, faded – repaint
- Missing Crosswalk - paint
- Maintenance needed (describe)
Pot holes
Sidewalk cracks
Overgrown buses/trees
- Existing Crossing Signal (works)
- Existing Crossing Signal (does not work)

SAFE ROUTES PEEKSKILL

saferoutespeekskill@gmail.com www.saferoutespeekskill.com

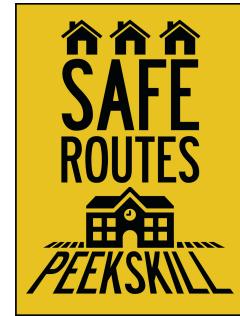

- **One-Way/Do Not Enter School Days Sign-** Is there a sign, note its location, if it has any hours listed. Please take a photo of the sign and label the spots on the map and the corresponding photo (continue the numbering from the School Zone Signs)



- **Crosswalks-** Is one present on each side of the intersection? What is its condition?
Mark Green if present and paint is bright and visible
Mark Blue if present and paint is faded/hard to see
Mark Red if no crosswalk is there, or it's partial (such as partially paved over/patched)
- **Maintenance Needed-** If you notice something that needs work, please mark it on your map, and make a list. Items such as Potholes, Cracked Sidewalks, Overgrown Bushes or Trees that block the walkways. We will send this list to the city to look into taking care of.
- **Pedestrian Crossing Signal-** Intersections with a Stop light for cars should have a crossing signal for pedestrians. Please let us know if the signal is working or not. The signal working means both the "Walking Man" and the "Stop Hand" light up, as well as the number count down. If any part is out, mark it as Does Not Work, please.




Please complete your School Crosswalk Survey by Friday March 4th for us.

We will compile the data and be sharing it with the city on March 16th.



CITY OF PEEKSKILL

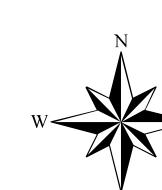

Maps Update

MRB GROUP
ENGINEERING, ARCHITECTURE, SURVEYING

GRAPHIC SCALE

RE


VISION TABLE


SPECIAL DIS

ICTS

LEO


ND ahead

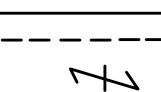 BLOCK NUMBER 2 CALCULATED ACREAGE 100 A(C) DEED ACREAGE 17.5 A SCALED DIMENSION 225'S DEED DIMENSION 173.2' 	<table border="1" style="margin-left: auto; margin-right: auto;"> <tr> <td></td> <td>23.09</td> <td>23.10</td> </tr> <tr> <td>22.16</td> <td></td> <td>23.14</td> </tr> <tr> <td>22.20</td> <td>23.70</td> <td>23.18</td> </tr> </table> <p style="text-align: center;">SHEET INDEX</p>		23.09	23.10	22.16		23.14	22.20	23.70	23.18	<p style="text-align: center;">TAX MAP</p> <p style="text-align: center;">CITY OF PEEKSKILL</p> <p style="text-align: center;">WESTCHESTER COUNTY,</p> <p style="text-align: center;">NEW YORK</p> <p style="text-align: right;">MAP DATE <u>MAY 1, 2021</u></p>
	23.09	23.10									
22.16		23.14									
22.20	23.70	23.18									

 

CITY OF PEEKSKILL

NOTE: THIS MAP IS COMPILED FOR TAX ASSESSMENT PURPOSES ONLY.

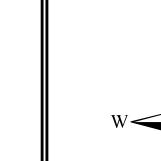

MRB GROUP
ENGINEERING, ARCHITECTURE, SURVEYING, P.C.
PARCEL DATA COMPILED IN 1987 BY STONE & WEBSTER ENGINEERING CORPORATION NEW YORK, N.Y.
PLANIMETRIC DATA COMPILED IN 1987 BY GEOD CORPORAION OAK RIDGE, N.J.

GRAPHIC SCALE
100 0 100
1" = 100'

COORDINATES BASED ON NEW YORK STATE PLANE COORDINATE SYSTEM EAST ZONE NAD-83

PEEKSKILL SCHOOL DISTRICT

REVISION TABLE

DATE MADE BY

REVISIONS

P/O 33.13-18-2

SEE SHEET 33.17

MATCH LINE

SEE SHEET 33.14


P/O 33.13-18-2

SEE SHEET 33.14


33.13

TAX MAP
CITY OF PEEKSKILL
WESTCHESTER COUNTY,
NEW YORK

MAY 1, 2021

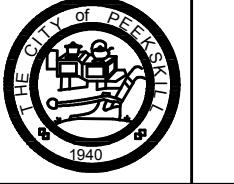

CITY OF PEEKSKILL

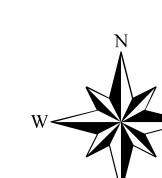

THIS MAP IS COMPILED FOR ASSESSMENT PURPOSES ONLY

Maps Updated By:

MRB GRC

ENGINEERING, ARCHITECTURE

A graphic scale bar consisting of two parallel horizontal lines. Between them are five evenly spaced tick marks labeled 50, 0, and 50 from left to right. Below the scale bar is the text "1\" data-bbox="715 415 785 445" style="text-align: center;">" = 50'

D

REVISION TAB

-E	SPECIAL DIS
/VISIONS	
	PEEKSKILL SCHOOL DISTRICT
	PD001

PROPERTY LINE	
ROAD	
RAILROAD	
RIGHT-OF-WAY	

LEGEND

HEET OUTLINE	— — —	ORIGINAL LOT LINE	—
LOCK LIMIT LINE	- - - - -	COMMON OWNER	
HATCH LINE	- - 1 -	TICS	
		TAX MAP PARCEL NUMBER	


	BLOCK NUMBER	(2)	22.20
	CALCULATED ACREAGE	100 A(C)	32.08
	DEED ACREAGE	17.5 A	66.00

7	23.78
	33.22
9	33.30

TAX MAP
CITY OF PEEKSKILL
WESTCHESTER COUNTY,
NEW YORK


MAP DAT

33.21

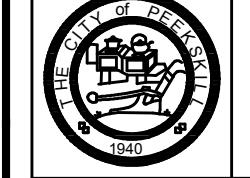

CITY OF PEEKSKILL

NOTE: THIS MAP IS COMPILED FOR TAX ASSESSMENT PURPOSES ONLY.

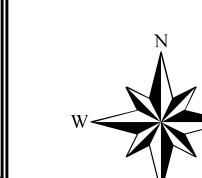

MRB GROUP
ENGINEERING, ARCHITECTURE, SURVEYING, P.C.
PARCEL DATA COMPILED IN 1987 BY STONE & WEBSTER ENGINEERING CORPORATION NEW YORK, N.Y.
PLANIMETRIC DATA COMPILED IN 1987 BY GEOD CORPORAION OAK RIDGE, N.J.

GRAPHIC SCALE
50 0 50
1" = 50'

COORDINATES BASED ON NEW YORK STATE PLANE COORDINATE SYSTEM EAST ZONE NAD-83

REVISIION TABLE

DATE MADE BY

REVISIONS

PEEKSKILL SCHOOL DISTRICT
PD001

SPECIAL DISTRICTS

PROPERTY LINE ROAD
BLOCK LIMIT LINE COMMON OWNER
RIGHT-OF-WAY MATCH LINE
CITY LINE SPECIAL DISTRICT LINE
COUNTY LINE WATER OUTLINE

ORIGINAL LOT LINE
TAX MAP PARCEL NUMBER COORD. LOCATOR POSITION
SUBLOT NUMBER SCALED DIMENSION
DEED ACREAGE DEED DIMENSION

LEGEND

②

32.08

33.21

33.22

32.08

33.30

32.12

33.37

33.38

32.08

33.30

32.12

33.38

32.08


 
33.30

32.12

33.38


TAX MAP
CITY OF PEEKSKILL
WESTCHESTER COUNTY,
NEW YORK
MAP DATE MAY 1, 2021

33.29

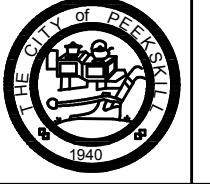

CITY OF PEEKSKILL

THIS MAP IS COMPILED FOR ASSESSMENT PURPOSES ONLY

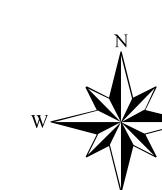

Maps Updated By:

MRB GROUP
ENGINEERING, ARCHITECTURE, SURVEYING

100 0 100


1" = 100'

A horizontal bar chart titled 'U.S. GOVERNMENT' with a subtitle 'ARE YOU SATISFIED WITH THE WAY THINGS ARE GOING?' The y-axis is labeled 'PERCENTAGE OF RESPONDENTS' with values 0, 10, 20, 30, 40, 50, 60, 70, 80, 90, and 100. The x-axis categories are 'GOVERNMENT IS RUN BY FEW PEOPLE', 'GOVERNMENT IS RUN FOR ALL', and 'NO ANSWER'. The bars show approximately 90% for 'GOVERNMENT IS RUN BY FEW PEOPLE', 7% for 'GOVERNMENT IS RUN FOR ALL', and 3% for 'NO ANSWER'.

CATEGORY	PERCENTAGE
GOVERNMENT IS RUN BY FEW PEOPLE	90
GOVERNMENT IS RUN FOR ALL	7
NO ANSWER	3

SPECIAL DISTRICTS

PROPERTY LINE		SHEET OUTLINE
ROAD		BLOCK LIMIT L
RAILROAD		MATCH LINE
RIGHT-OF-WAY		SPECIAL DISTR
CITY LINE		
COUNTY LINE		WATER OUTLIN

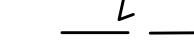
LEGEND	
LINE	— — —
LINE	- - - - -
RICT LINE	- - - L -
NE	
	ORIGINAL LOT LINE
	COMMON OWNER
	TICS
	TAX MAP PARCEL NUMBER
	COORD. LOCATOR POSITION
	SUBLOT NUMBER


	BLOCK NUMBER	(2)
	CALCULATED ACREAGE	100 A(C)
	DEED ACREAGE	17.5 A
	SCALED DIMENSION	225'S
76	DEED DIMENSION	173.2'

23.13	23.14	24.15
23.78		23.19
33.22	33.06	33.07

TAX MAP
ITY OF PEEKSKILL
ESTCHESTER COUNTY,
NEW YORK

 
23.18



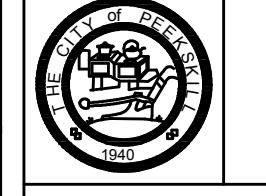

CITY OF PEEKSKILL

NOTE: THIS MAP IS COMPILED FOR TAX ASSESSMENT PURPOSES ONLY.

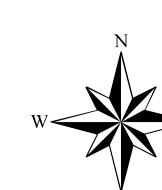

N
S
E
W

MRB GROUP
ENGINEERING, ARCHITECTURE, SURVEYING, P.C.

PARCEL DATA COMPILED IN 1987 BY STONE & WEBSTER ENGINEERING CORPORATION NEW YORK, N.Y.
PLANIMETRIC DATA COMPILED IN 1987 BY GEOGRAPHIC CORPORATION OAK RIDGE, N.J.

GRAPHIC SCALE

DATE MADE BY REVISIONS
1" = 50'

PEEKSKILL SCHOOL DISTRICT

PD001

COORD. LOCATOR POSITION

173.2

WATER OUTLINE

PROPERTY LINE

ROAD

RIGHT-OF-WAY

CITY LINE

COUNTY LINE

SHEET OUTLINE

BLOCK LIMIT LINE

MATCH LINE

SPECIAL DISTRICT LINE

WATER OUTLINE

ORIGINAL LOT LINE

COMMON OWNER

NAME

TAX MAP PARCEL NUMBER

COORD. LOCATOR POSITION

SUBLOT NUMBER

BLOCK NUMBER

CALCULATED ACREAGE

100 A(C)

DEED ACREAGE

17.5 A

225 S

173.2

LEGEND

14

15

16


42

43


33.37

TAX MAP
CITY OF PEEKSKILL
WESTCHESTER COUNTY,
NEW YORK

MAY 1, 2021

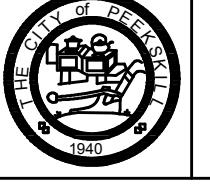

CITY OF PEEKSKILL

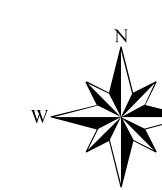

THIS MAP IS COMPILED FOR
ASSESSMENT PURPOSES ONLY

Maps Update

MRB GROUP

ENGINEERING, ARCHITECTURE, SURVEYING

NG, P.C.

COMPILED IN 1987 BY:
ORATION
E, N.J.

50 0

1" = 50'

COORDINATES BASED
NEW YORK STATE PLANE COORDINATES
EAST ZONE N.A.D.⁸³

三

The diagram consists of a horizontal black bar on the left and a vertical stack of five horizontal black bars on the right. The top bar on the right has the letter 'D' written on it.

MADE BY

MADE BY	

E VISIONS

ISIONS	PEEKSKILL SCHOOL DISTRICT
	PD001

1



PROPERTY LINE
ROAD
RAILROAD
RIGHT-OF-WAY
CITY LINE
COUNTY LINE

1

ORIGINAL LOT LINE			
COMMON OWNER	7	BLOCK NUMBER	(2)
TICS	+	CALCULATED ACREAGE	100 A(C)
TAX MAP PARCEL NUMBER	14	DEED ACREAGE	17.5 A
COORD. LOCATOR POSITION	•	SCALED DIMENSION	225'S
SUBLOT NUMBER	76	DEED DIMENSION	173.2'
33.21	33.22	33.06	
33.29		33.06	
33.37	33.38	33.10	
SHEET INDEX			


TAX MAP
CITY OF PEEKSKILL
WESTCHESTER COUNTY,
NEW YORK

 33.30

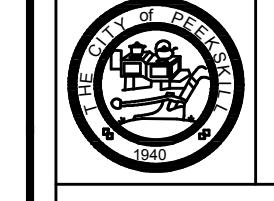

CITY OF PEEKSKILL

NOTE: THIS MAP IS COMPILED FOR TAX ASSESSMENT PURPOSES ONLY.

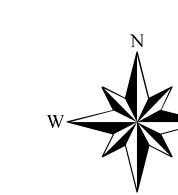

Maps Updated by:

MRB GROUP
ENGINEERING, ARCHITECTURE, SURVEYING, P.C.

PARCEL DATA COMPILED IN 1987 BY STONE & WEBSTER ENGINEERING CORPORATION NEW YORK, N.Y.

PLANIMETRIC DATA COMPILED IN 1987 BY GEOID CORPORATION OAK RIDGE, N.J.

N

S

E

W

NE

SW

SE

NO

SO

WE

EA

SE

NO